

IS:
LINE

BUILDING DATA:

BLDG. PLAN NO.: 18-1A
 ADDRESS: _____
 LOT AREA: 6328 S.F.
 NO. OF STORIES: _____
 EXT. COLOR SCHEME: _____
 PAD GRADE: 164.4 FT.
 FF ELEVATION: 165.1 FT.
 GARAGE FF FRONT: 164.9 FT.
 GARAGE FF REAR: 165.1 FT.

OR
IENT
IENT
T

NOTES:

THIS PLOT PLAN IS PREPARED TO ILLUSTRATE THE FROM BUILDING FOUNDATION TO PROPERTY LINE, DI ELEVATIONS, AND DIRECTION OF DRAINAGE FLOW TO ORDINANCES WITH THE PURPOSE OF BUILDING PERA SHOWN IS APPROXIMATE EXCEPT FOR THOSE SETBA REQUIRED BY ORDINANCE. THIS PLAN WAS PREPARE TOOL AND DOES NOT REPRESENT THE "AS-BUILT" SOME DEGREE FROM THE DESIGN.

LOCATION OF UTILITIES SHOWN ARE APPROXIMATE. VERIFY LOCATION AND DEPTH OF UTILITIES WITH AP PRIOR TO STARTING WORK.

SLOPE GRADE 1/4" PER FOOT FOR 4'-0" MIN. AWA

THE DRIVEWAY SHALL BE 4" CONCRETE AND SHALL

DESIGN TO COMPLY WITH ANY NOTES OR RESTRICTI MAP, SUBDIVISION IMPROVEMENT PLANS, ZONING OR OR OTHER APPLICABLE ITEMS.

FOR ALL DIMENSIONS OF PROJECTIONS, SEE ARCHIT


IT IS TO BE UNDERSTOOD THAT THE DRAINAGE ARE SHALL NOT BE ALTERED, CHANGED, BLOCKED, MODI CONSTRUCTED BY OWNER CONTRARY TO WHAT IS D PLAN.

THESE CONDITIONS RUN WITH THE BINDING ON ALL SUBSEQUENT OW

REVIEWED WITH OWNER(S)

OWNER(S)

DEVELOPERS NAME

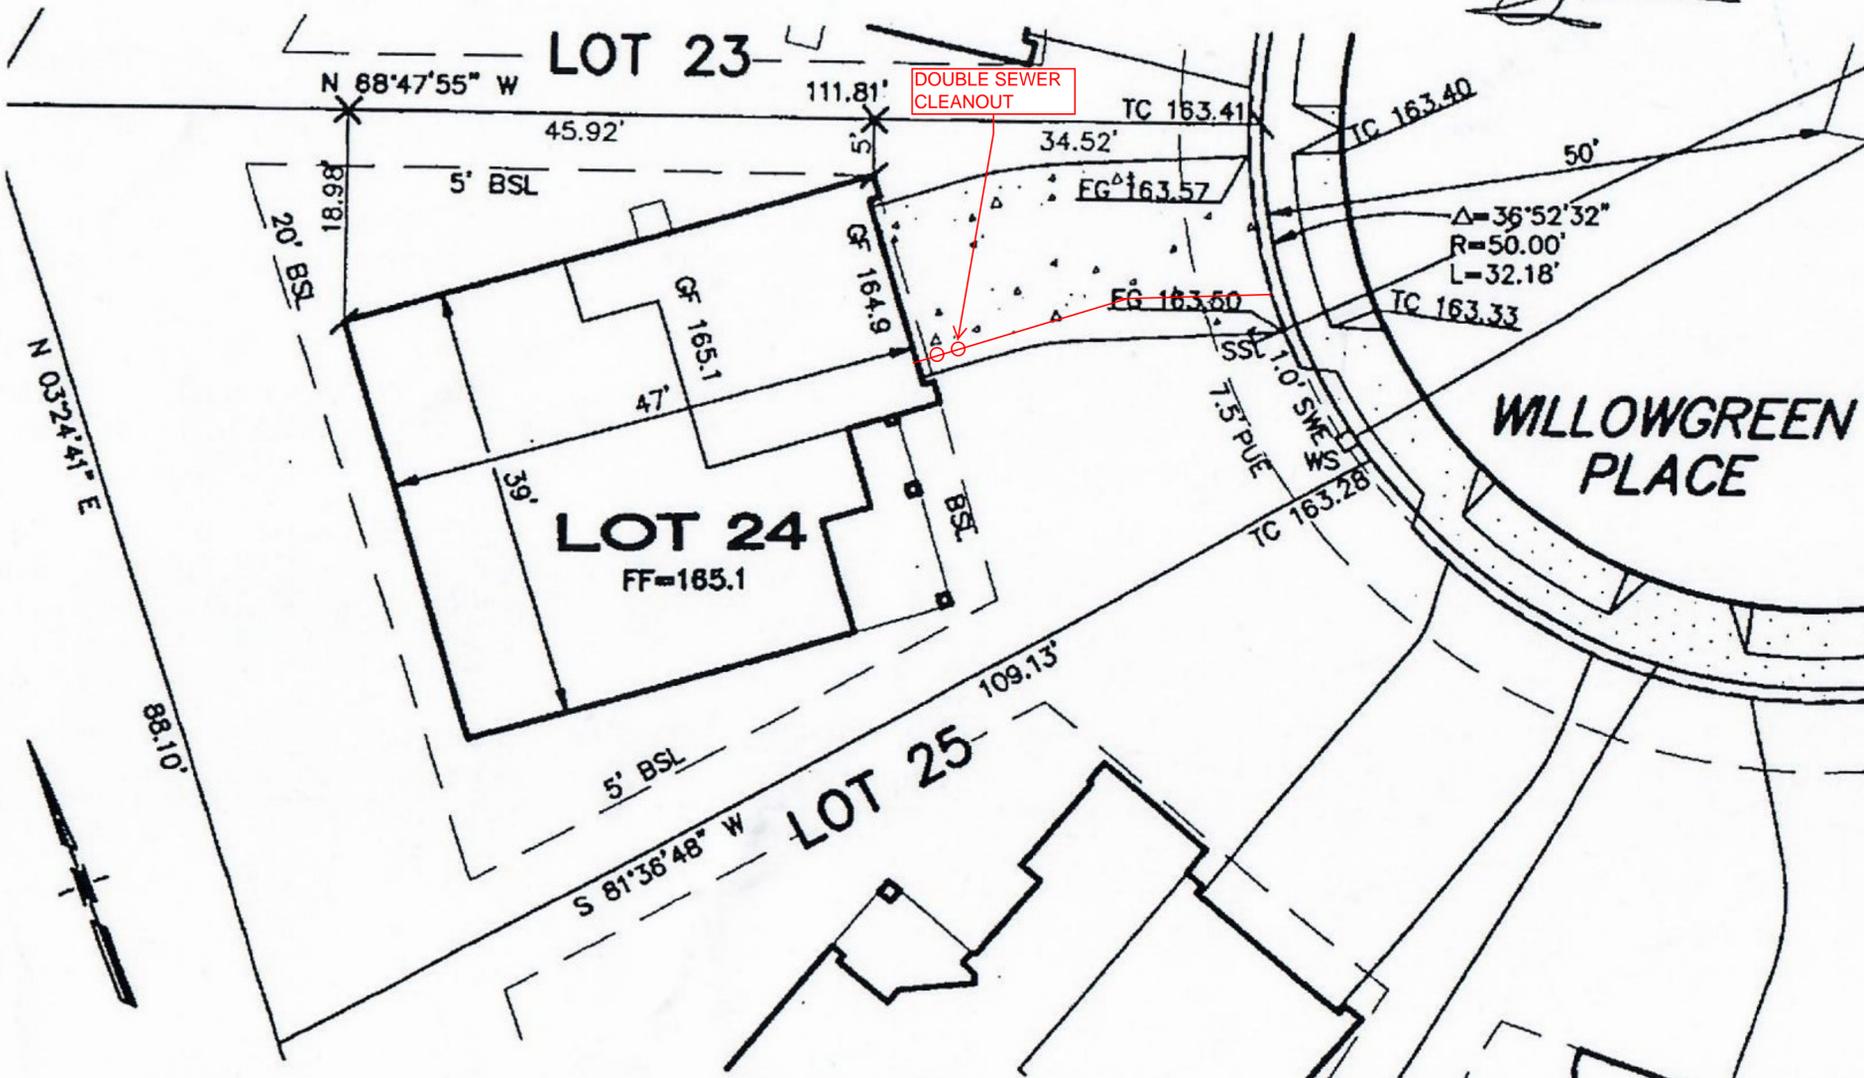

Handwritten signature

20' DATE: MARCH 1999 DRAWN BY: B.L.B.

PLOT PLAN - LOT NO. 24
 EVERGREEN
 SONOMA COUNTY, CALIFORNIA

APPROVAL: REGISTERED PROFESSIONAL ENGINEER
 MARY-JANE STIMS
 DEVELOPERS NAME: CARLILE, MACY
 DATE: 4/23/99

REVISIONS
 1-1

CARLILE, MACY
 CIVIL ENGINEERS • URBAN PLANNERS •
 LAND SURVEYORS • LANDSCAPE ARCHITECTS
 15 THIRD STREET • SANTA ROSA, CA 95401 • TEL 707-543-4451 • FAX 707-543-4422