

ABBREVIATIONS:

BSL	BUILDING SETBACK LINE	PDE	PRIV. DRAIN. EASEMENT
CB	CATCH BASIN	PG	PAD GRADE
DI	DROP INLET	PUE	PUBLIC UTIL. EASEMENT
FC	FACE OF CURB	SS	SEWER SERVICE
FF	FINISH FLOOR	SWE	SIDEWALK EASEMENT
FG	FINISH GRADE	TC	TOP OF CURB
FL	FLOW LINE	TG	TOP OF GRATE
GF	GARAGE FINISH FLOOR	WS	WATER SERVICE

BUILDING DATA:

BLDG. PLAN NO.:	1AR	PAD GRADE:	162.7 FT.
ADDRESS:		FF ELEVATION:	163.4 FT.
LOT AREA:	6660 S.F.	GARAGE FF FRONT:	163.2 FT.
NO. OF STORIES:		GARAGE FF REAR:	163.4 FT.
EXT. COLOR SCHEME:			

NOTES:

THIS PLOT PLAN IS PREPARED TO ILLUSTRATE THE DIMENSIONAL RELATIONSHIP FROM BUILDING FOUNDATION TO PROPERTY LINE, DESIGN DRAINAGE CONTROL ELEVATIONS, AND DIRECTION OF DRAINAGE FLOW TO CONFORM WITH LOCAL ORDINANCES WITH THE PURPOSE OF BUILDING PERMIT ISSUANCE. INFORMATION SHOWN IS APPROXIMATE EXCEPT FOR THOSE SETBACKS WHICH ARE MINIMUMS REQUIRED BY ORDINANCE. THIS PLAN WAS PREPARED AS A CONSTRUCTION TOOL AND DOES NOT REPRESENT THE "AS-BUILT" CONDITION WHICH VARIES IN SOME DEGREE FROM THE DESIGN.

LOCATION OF UTILITIES SHOWN ARE APPROXIMATE. CONTRACTOR SHALL VERIFY LOCATION AND DEPTH OF UTILITIES WITH APPROPRIATE AGENCIES PRIOR TO STARTING WORK.

SLOPE GRADE 1/4" PER FOOT FOR 4'-0" MIN. AWAY FROM BUILDING, THE DRIVEWAY SHALL BE 4" CONCRETE AND SHALL BE 16' IN WIDTH. DESIGN TO COMPLY WITH ANY NOTES OR RESTRICTIONS SHOWN ON THE FINAL MAP, SUBDIVISION IMPROVEMENT PLANS, ZONING ORDINANCES, SOILS REPORT OR OTHER APPLICABLE ITEMS.


FOR ALL DIMENSIONS OF PROJECTIONS, SEE ARCHITECT'S FLOOR PLAN. IT IS TO BE UNDERSTOOD THAT THE DRAINAGE AREAS, SLOPES AND GRADES SHALL NOT BE ALTERED, CHANGED, BLOCKED, MODIFIED OR IN ANY WAY RE-CONSTRUCTED BY OWNER CONTRARY TO WHAT IS DEPICTED ON THIS PLOT PLAN.

THESE CONDITIONS RUN WITH THE LAND AND ARE BINDING ON ALL SUBSEQUENT OWNERS.

REVIEWED WITH OWNER(S) ONSITE:

OWNER(S) _____ DATE _____

DEVELOPERS NAME _____ DATE _____

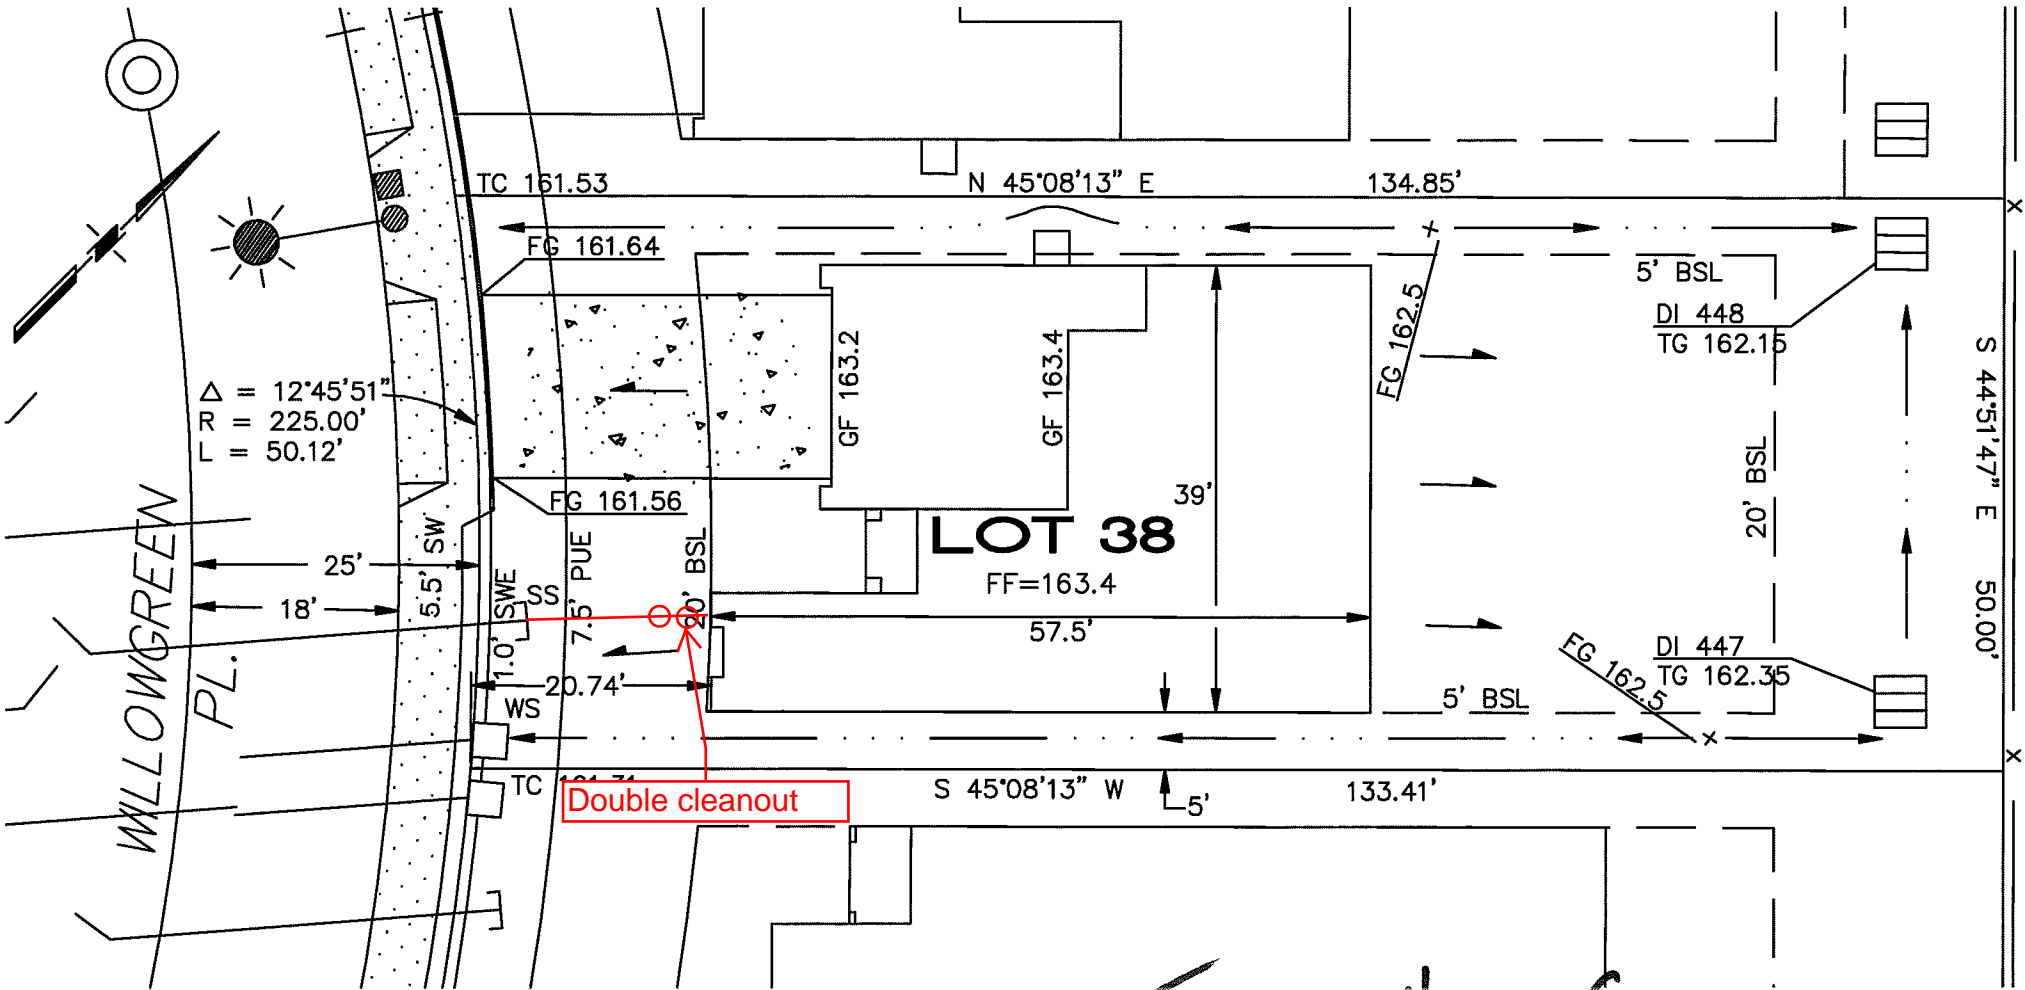

215 WillowGreen

PLAN SCALE 1" = 20'	DATE: DECEMBER 1998	DRAWN BY: D.W.S.	PLOT PLAN - LOT NO. 38	APPROVAL:	REVISIONS:
			EVERGREEN SONOMA COUNTY, CALIFORNIA	DEVELOPERS NAME _____ DATE _____ CARLILE, MACY _____ DATE _____	_____ _____ _____ _____ _____